




AS-BUILT DOCUMENTATION  
OSP Field Construction

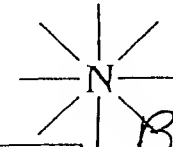


B008351

B08351

Sheet 1 of 1	Dated 5.17.00	Project # 5467	Date 5.17.00
W.O. #	Span CANAL	Title	To

MP/SHT # NOT TO SCALE \* SPRINT LINE 7' TO BOTTOM CANAL 10' TO BOTTOM C/S FROM ~~SPRINT~~ OF RAIL # MP/SHT

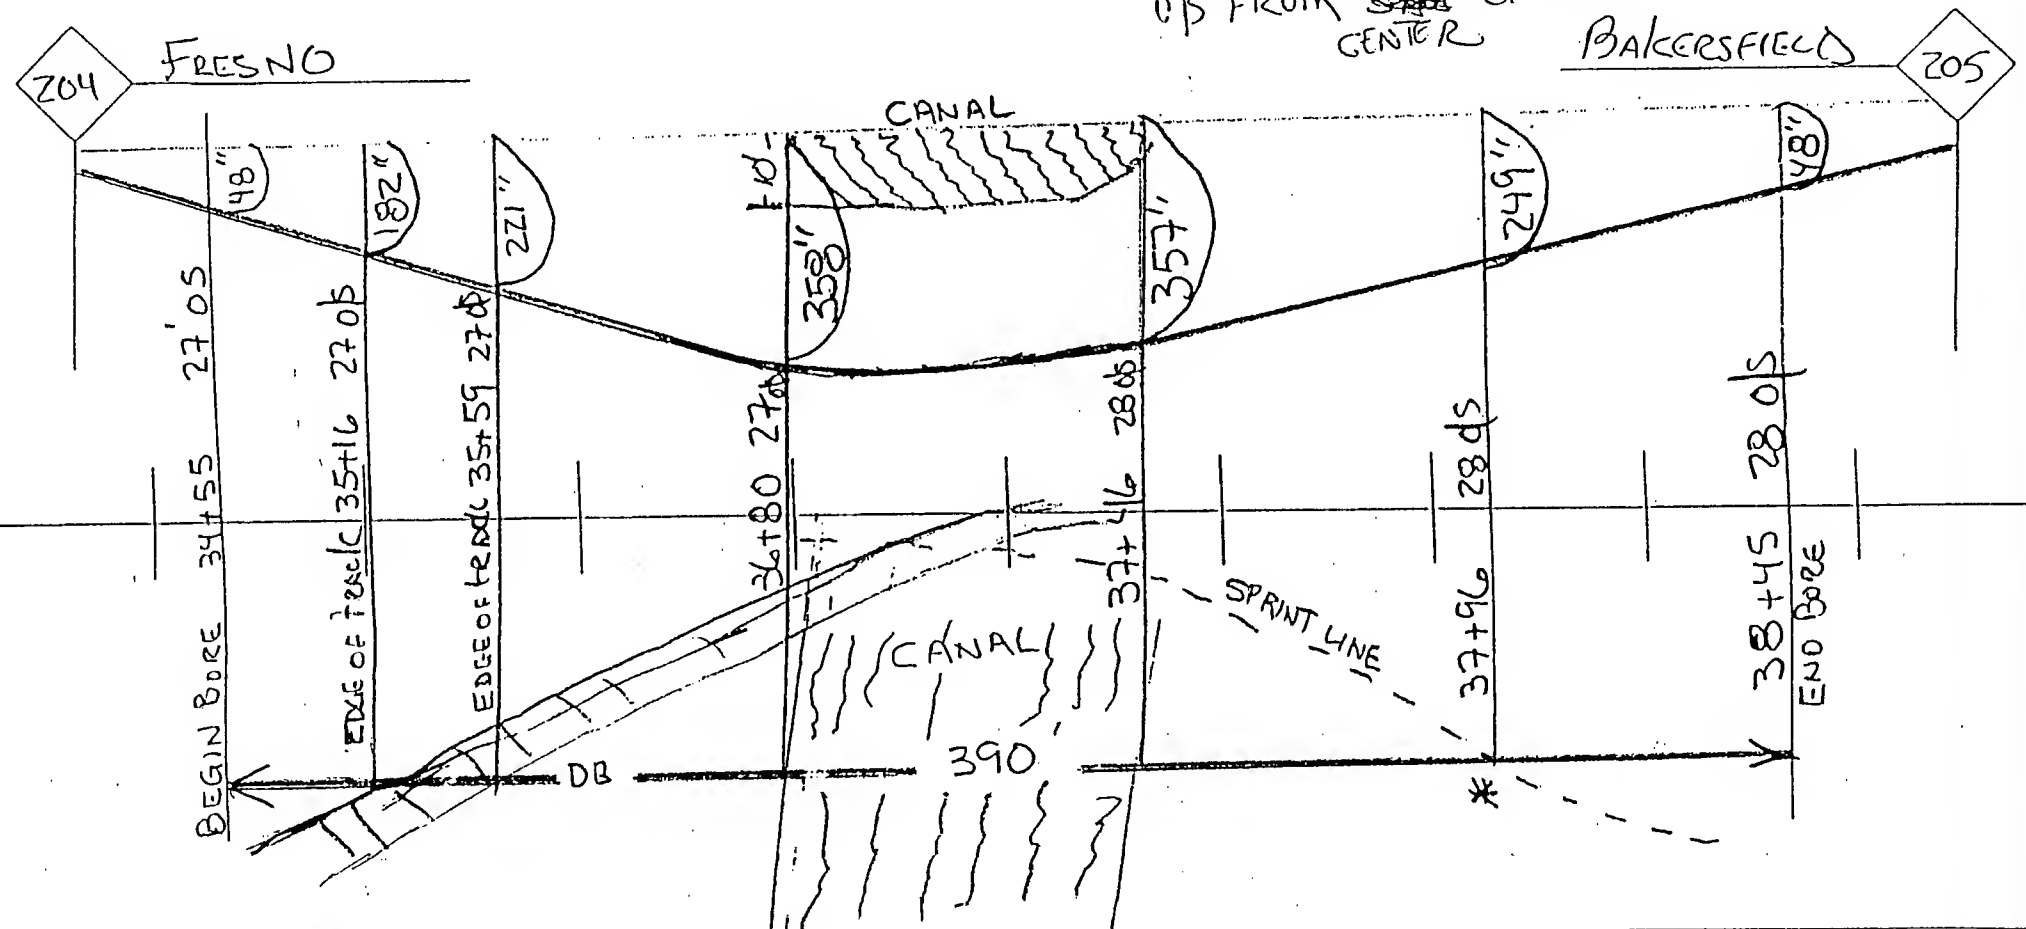


Materials used:	
Construction Contractor	Posted By
Inspector	Engineering Company
Inspection Cr	Date

B08351

# PROFILE INFORMATION


(Inspector to Fill Out)

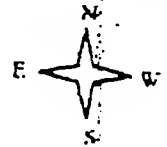

Date: 5-16-88

Road Arroyo Gas Line(s) Electric Line(s) (FOC) (RR Track(s)) River Creek  
 Burn Other (Specify): ① IRR CANAL

## TOP PLAN

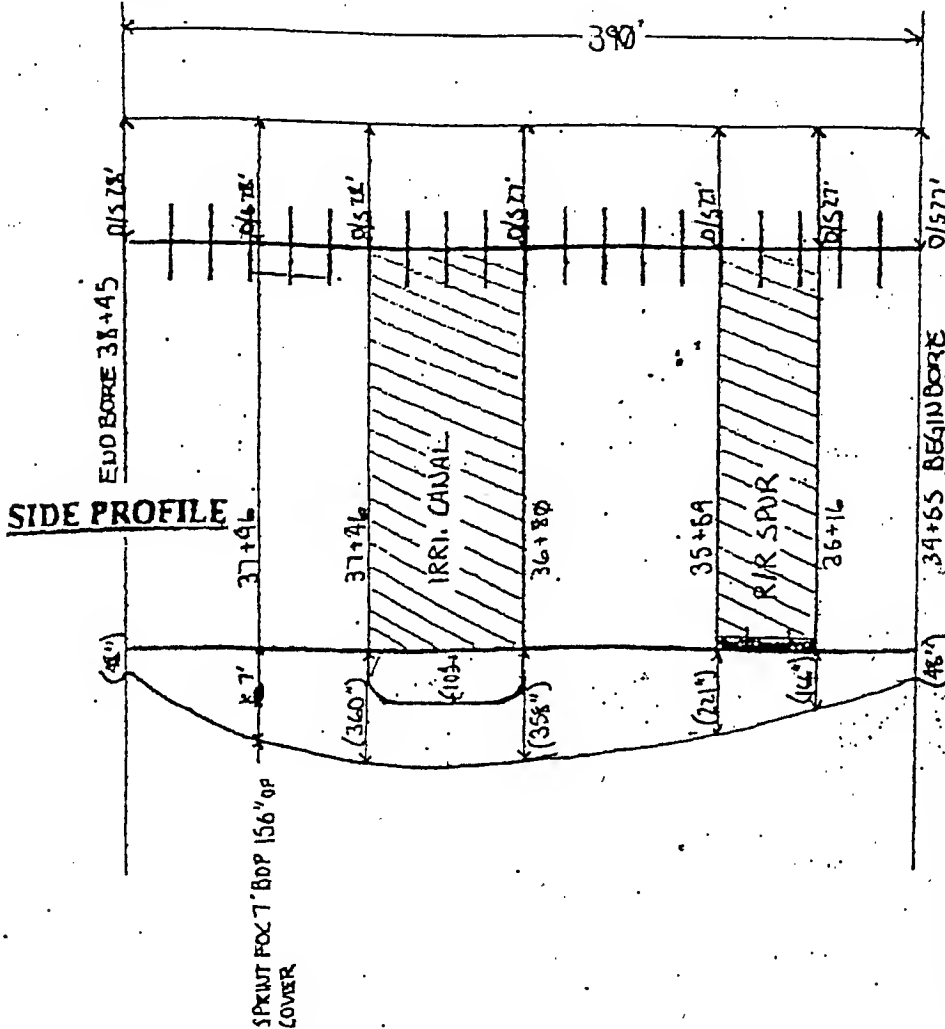

## SIDE PROFILE

\*STEM LIST RUNS SOUTH TO NORTH

# Stem	Pitch%	Depth	CVS	9th*
1	-32	59'	28'	38+45
2	-32	112'	28'	
3	-32	183'	28'	
4	-36	241'	28'	37+46
5	-28	307'	28'	
6	-20	344'	28'	
7	-12	357'	28'	37+46
8	-4	360'	28'	
9	+1	WATER		
10	+3	WATER		
11	+4	WATER		
12	+5	WATER		36+46
13	+5	356'	27'	
14	+10	338'	27'	
15	+12	317'	27'	
16	+12	299'	27'	
17	+10	280'	27'	
18	+12	265'	27'	
19	+12	256'	27'	
20	+14	238'	27'	
21	+12	221'	27'	35+59
22	+12	202'	27'	
23	+12	182'	27'	35+46
24	+12	152'	27'	
25	+10	130'	27'	
26	+12	110'	27'	
27	+18	84'	27'	34+65
28	+24	40'	27'	

## BORE SUMMARY

Soil Conditions: (Dir) / Cobble / Rock  
 Begin Bore (Sta.): 34+55  
 Bore Pay Length: 390'  
 Casing Type: N/A  
 Duct Pipe Size: 14"  
 Subcontractor: ASI  
 Rig #: AZ  
 Owner: ASI

Job #: LEVEL THREE IRRIGATION CANAL FRESNO  
 End Bore (Sta.): 38+45  
 Proofing Pay Length: 390'  
 Casing Pay Length: N/A  
 # of Ducts: 12  
 Foreman Signature: [Signature]  
 Inspector Signature: [Signature]